

EXHIBIT 14
PRINCEMULTNOMAH COUNTY
DEPARTMENT OF ENVIRONMENTAL SERVICES/PERMIT SECTION
REPORT OF SUBSURFACE SEWAGE SYSTEMS

10862

Permit Number _____

Date 10/1/87Address 41025 SE Loudon Road

Lot _____ Block _____ Addition _____ T _____ R _____

Installer Dan RobertsOwner John ChamberlinCesspool _____ New () Replacement () _____

Septic Tank _____

Drainfield _____

Septic Tank/drainfield

Septic Tank/seepage pit _____

Seepage Pit _____


Land Feasibility Study No. 11E-67 Date _____

Remarks _____

Date of inspection 10/6/87Inspector Michael S. Chamberlin RE

SE LOUDBON RD

N

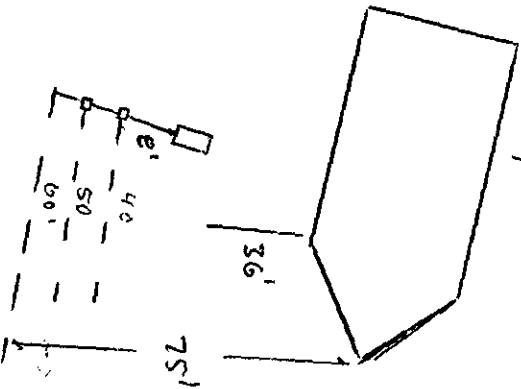

Handwritten notes or scribbles at the bottom left of the page.

CITY OF PORTLAND
ENVIRONMENTAL SOILS SECTION
REPORT OF SUBSURFACE SEWAGE SYSTEMS

PERMIT NO. 11562

DATE 6/27/89

ADDRESS 41025 SE Loudon Road

LOT _____ BLOCK _____ ADDITION _____ T _____ R _____

INSTALLER Tom Steenson

OWNER same

CESSPOOL _____ NEW () REPAIR () ALTERATION ()

SEPTIC TANK 1000 gallon

DRAINFIELD 265 lineal

SEPTIC TANK/DRAINFIELD _____


SEPTIC TANK/SEEPAGE PIT _____

SEEPAGE PIT _____

LAND FEASIBILITY STUDY NO. E3-E9 DATE _____

REMARKS _____

DATE OF INSPECTION 9/21/89 INSPECTOR Richard Stehling

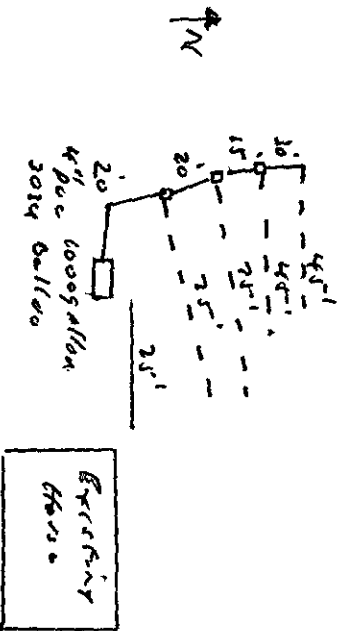

SE corner 20