
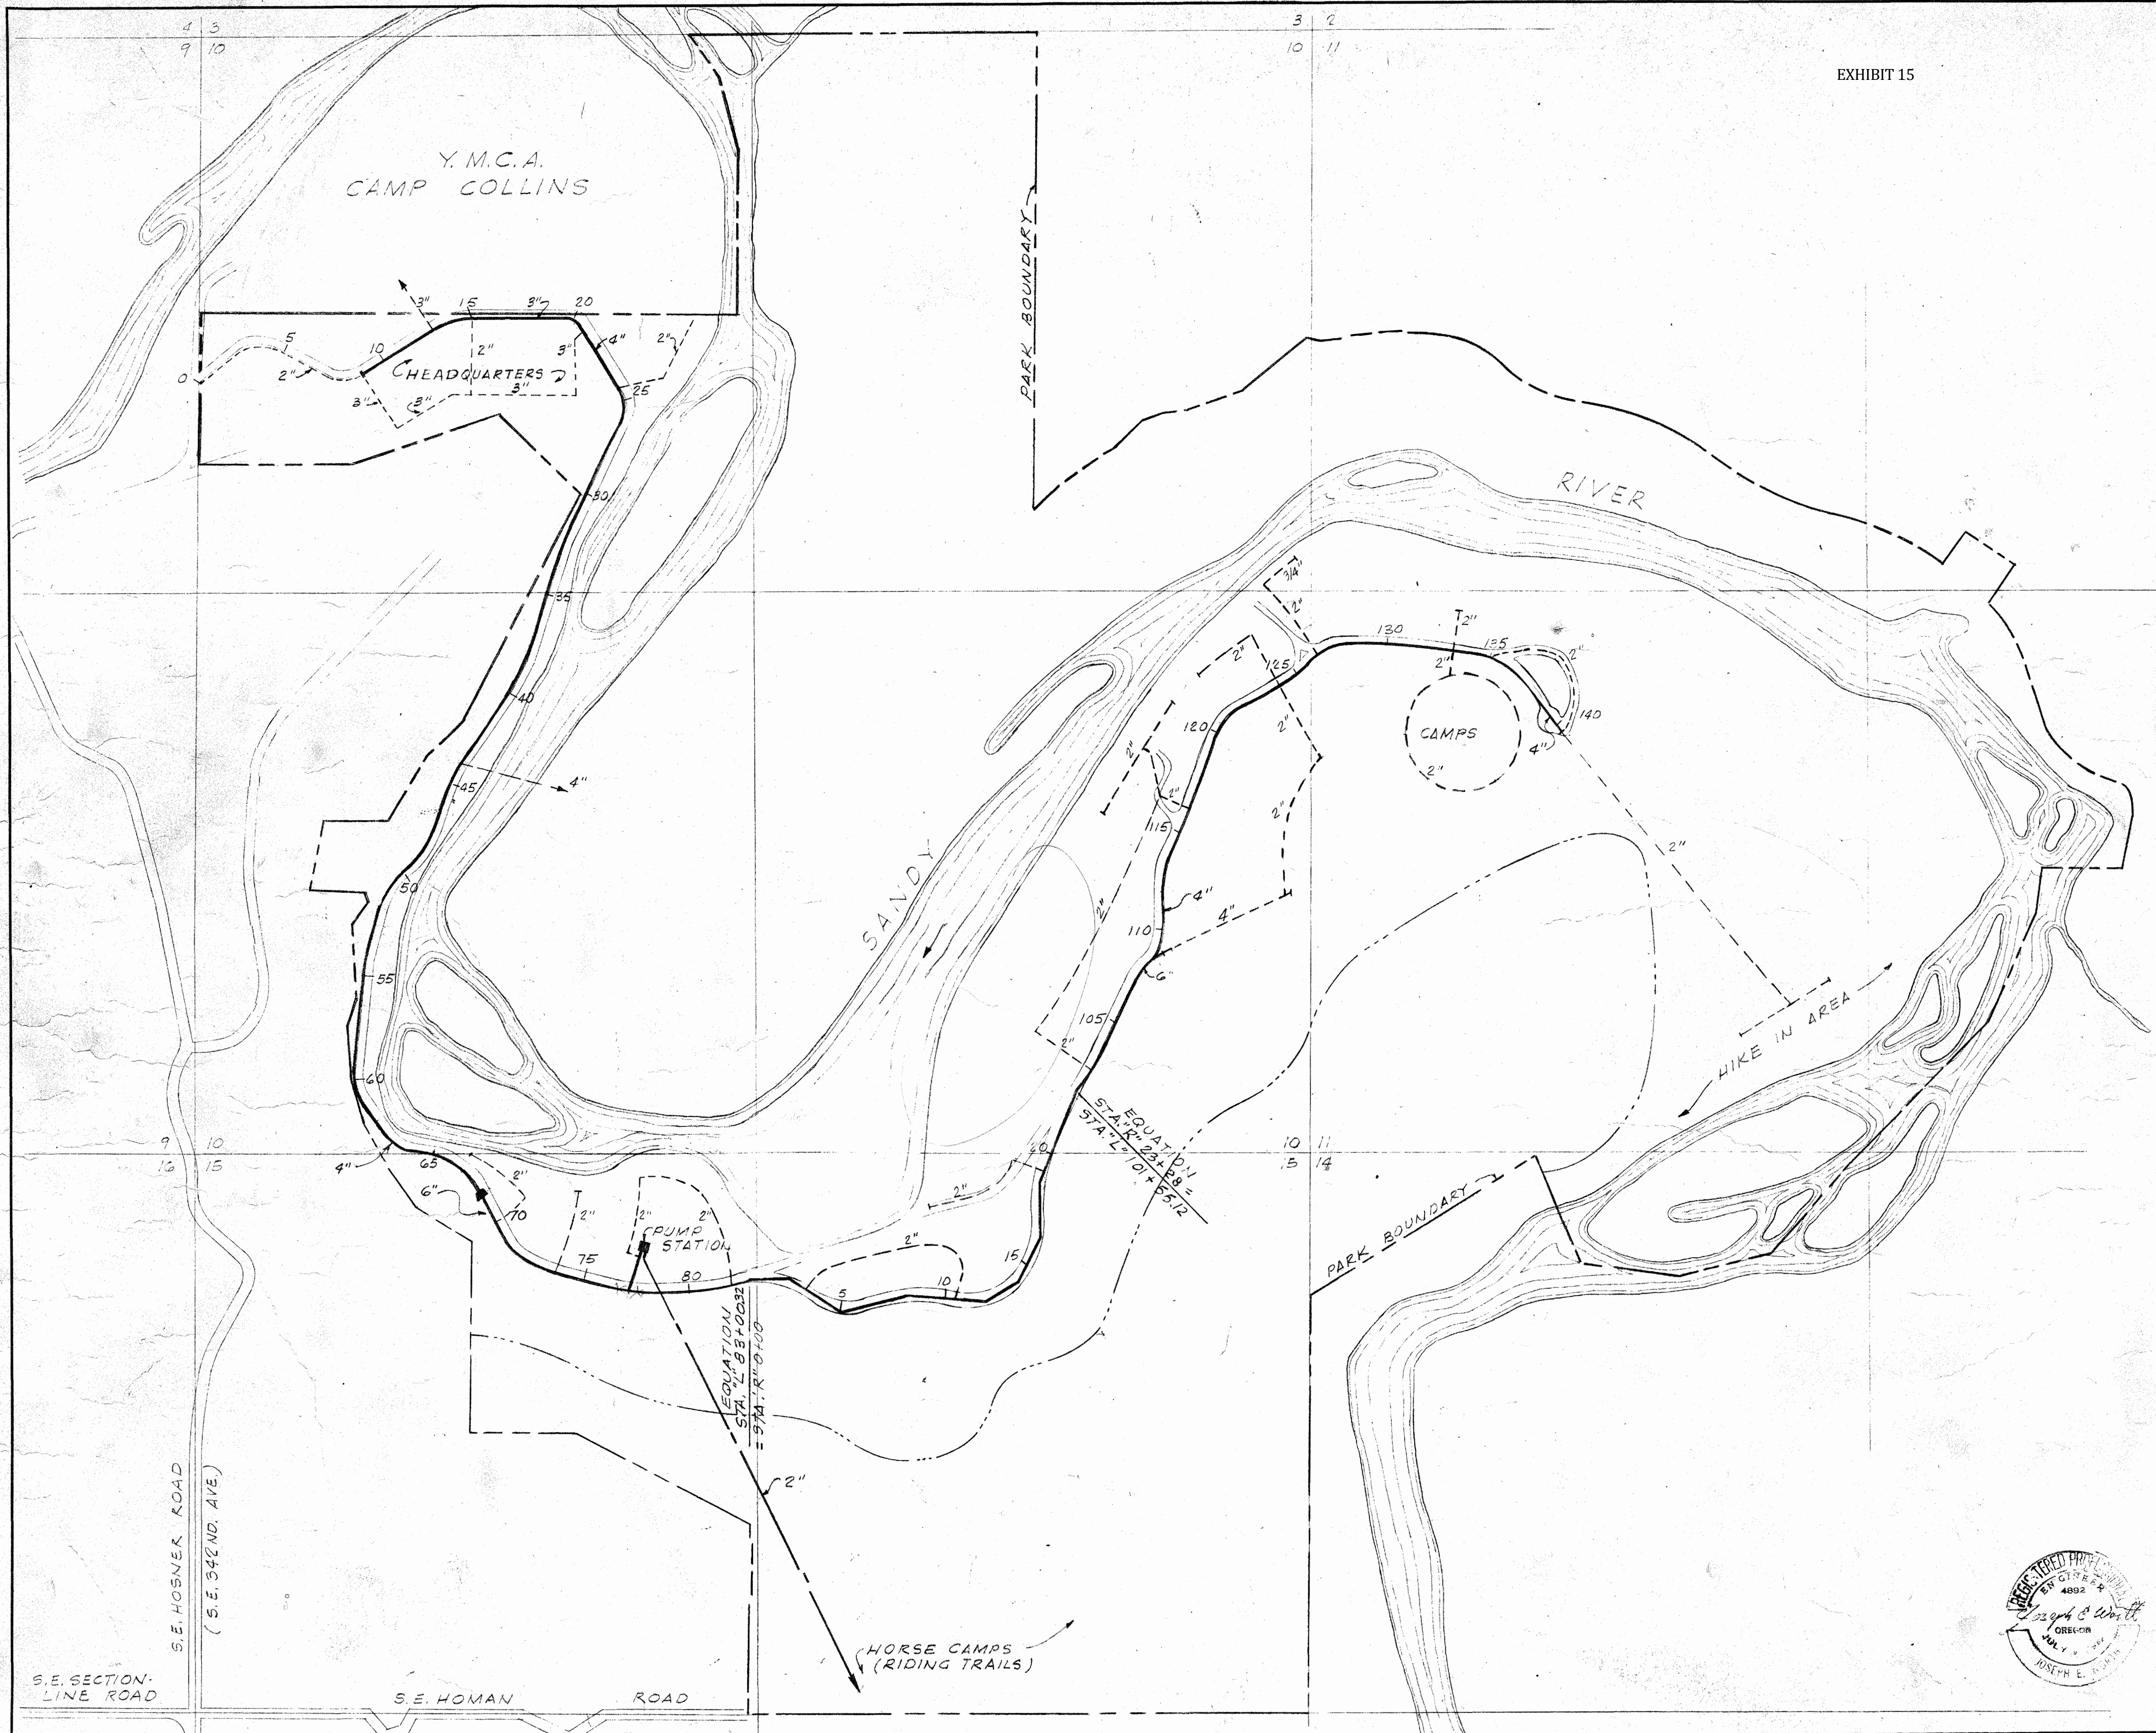


- LEGEND
- 6" DISTRIBUTION MAINS (THIS CONTRACT)
 - 3" FUTURE LATERALS (BY OTHERS)
 - 2" MAIN TO HIGH LEVEL AREA (BY OTHERS)
 - PARK BOUNDARY
 - LOW LEVEL DISTRIBUTION LIMIT
MAXIMUM ELEV. 1190 ± (OXBOW PARK ROAD DATUM)

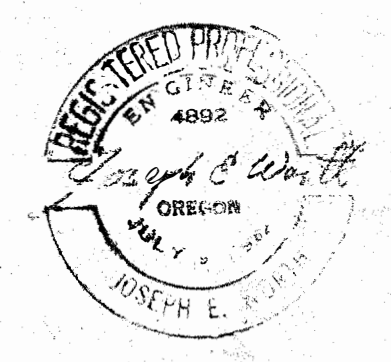

1	MAY 3, 65	GEN. REVISIONS	JCC	JEW
NO.	DATE	REVISIONS	BY	AP CK
COUNTY OF MULTNOMAH, OREGON DIVISION OF PARKS AND MEMORIALS				
OXBOW PARK WATER SYSTEM				
DISTRIBUTION SYSTEM MAP				
SCALE: 1" = 100'	DATE: JUNE, 1964	SHEET	OF 6	
DES. J.E.H.	CORNELL, HOWLAND, HAYES & MERRYFIELD		DWG. NO.	
DR. JCC	CONSULTING ENGINEERS		C3210-5	
CK. J.E.H.	BOISE CORVALLIS SEATTLE			