



Ground Floor Plan - 8062 square feet
As-Built Sketch

New Horizon Utility Construction, LLC. - Building

KEYSTONE Architecture Planning and Project Management LLC
T: 503-761-1362 F: 503-760-0534

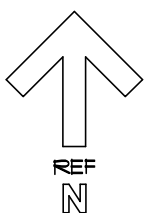


3/32" = 1'-0"
9/18/23

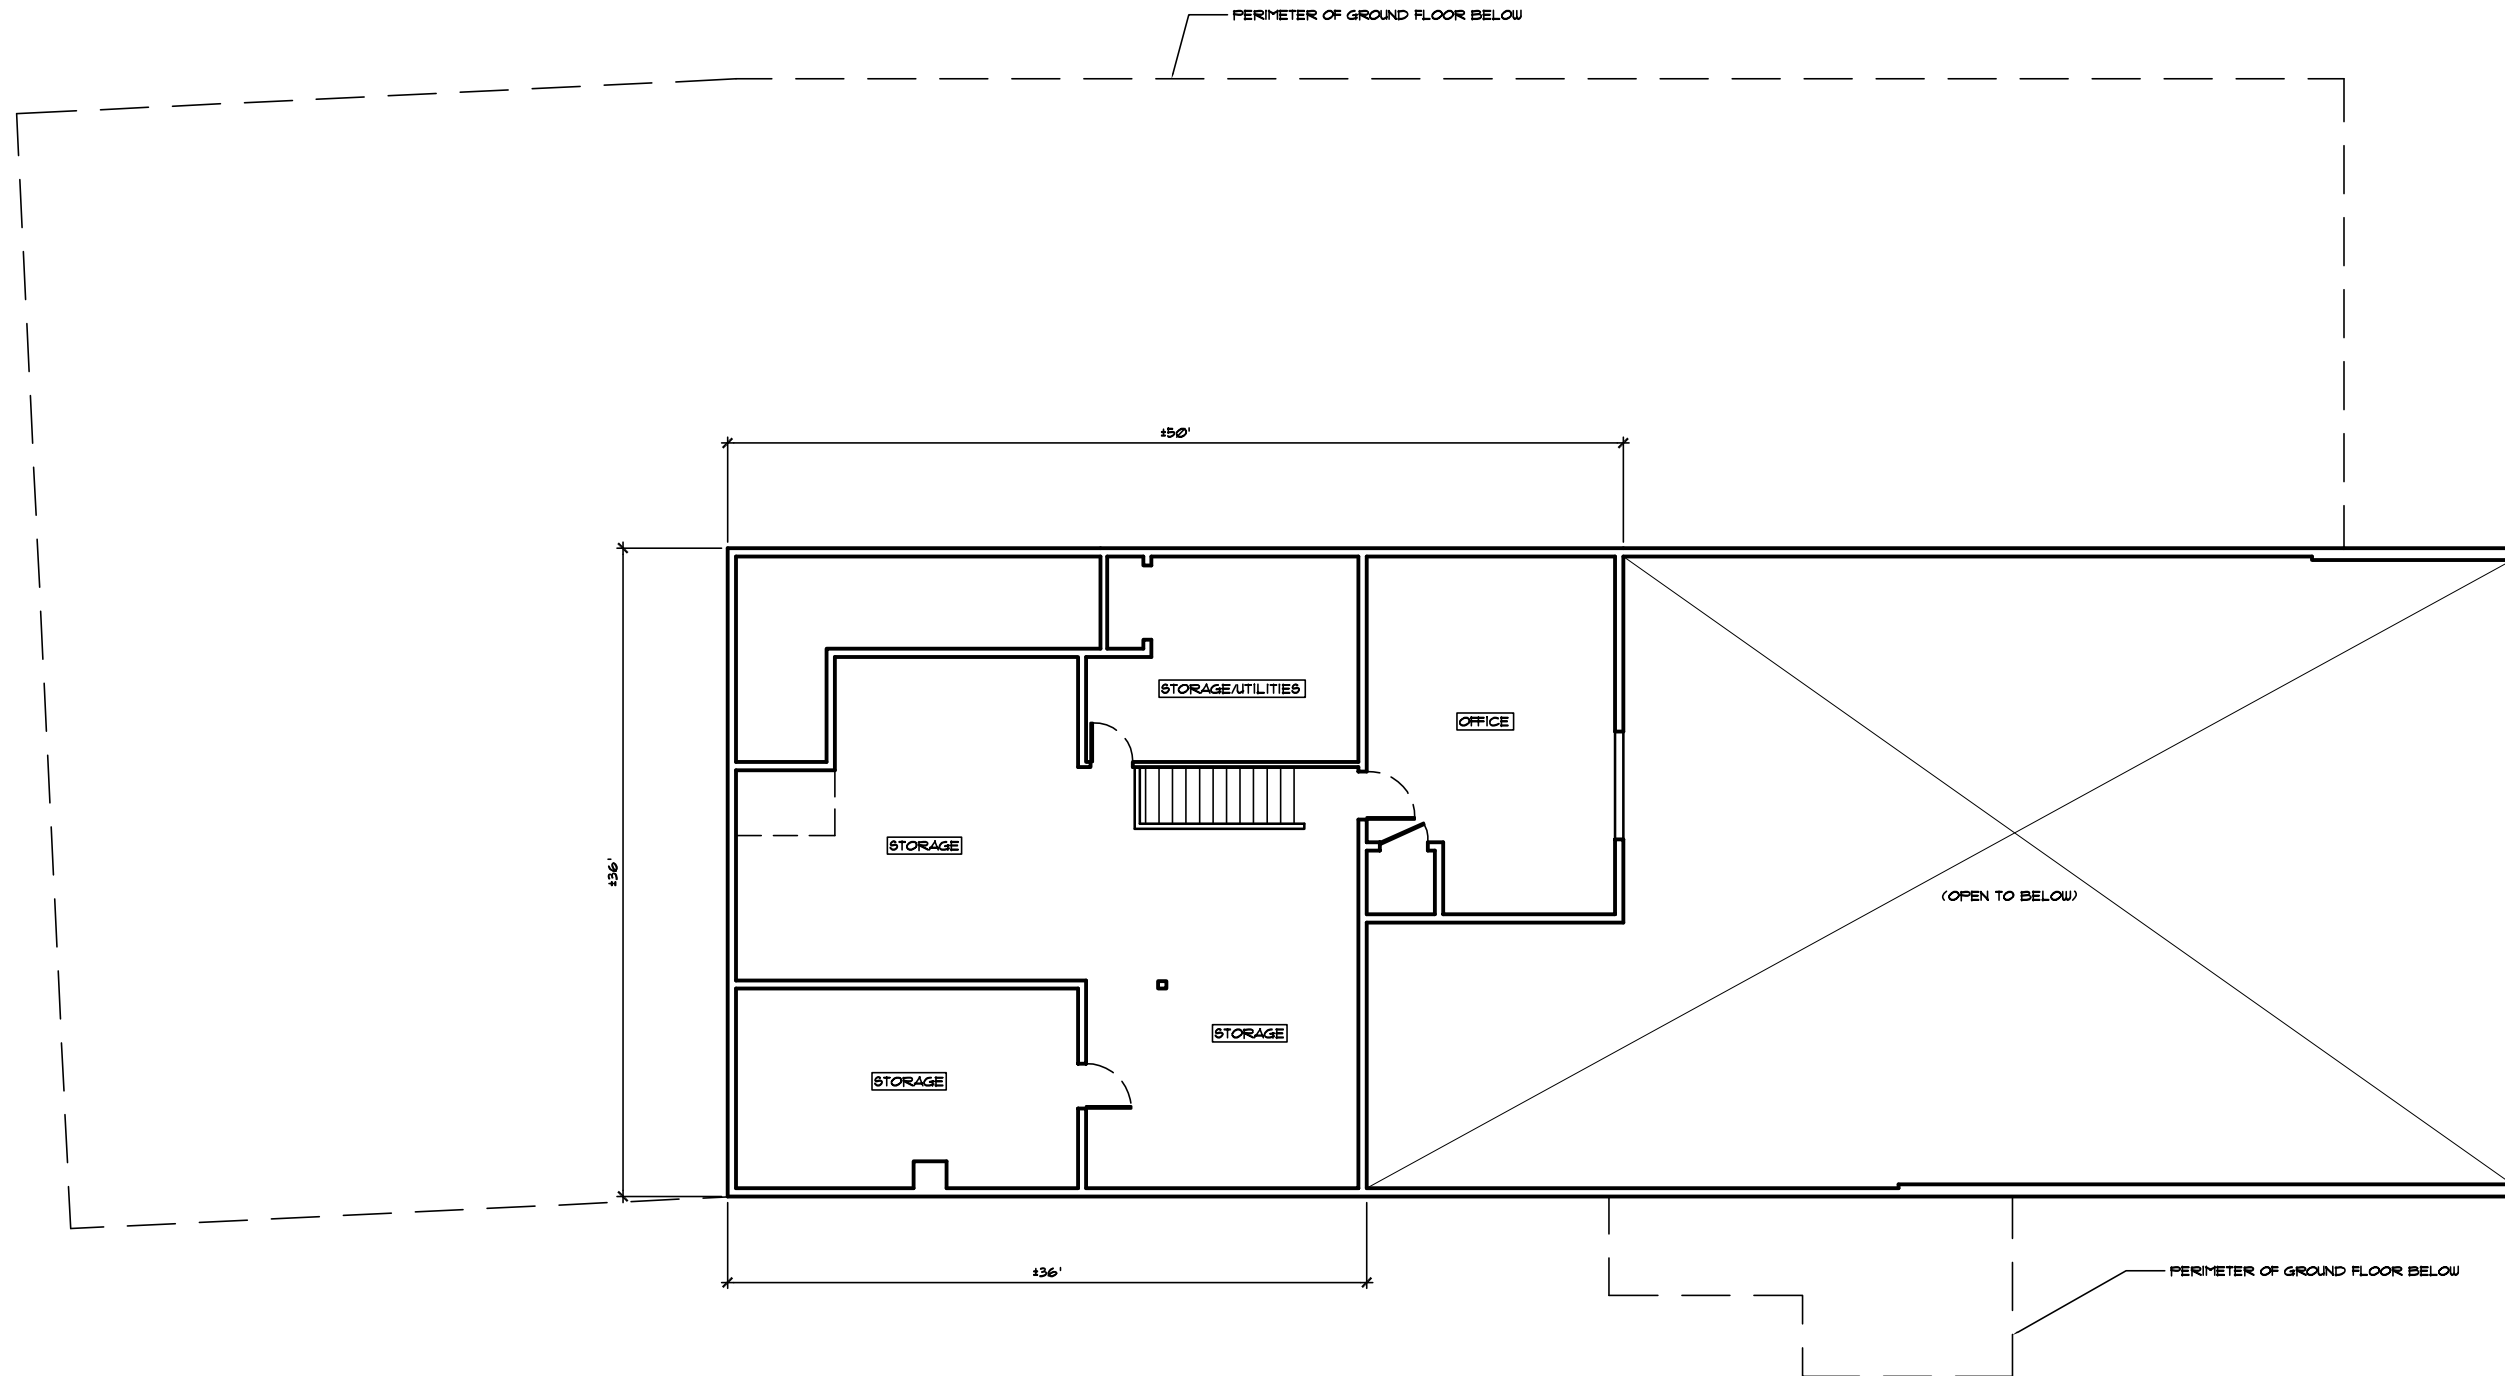


Second Floor Plan - 1496 square feet
As-Built Sketch

New Horizon Utility Construction, LLC. - Building


KEYSTONE Architecture Planning and Project Management LLC
T: 503-761-1362 F: 503-760-0534

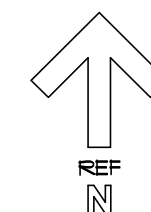

3/32" = 1'-0"
9/18/23

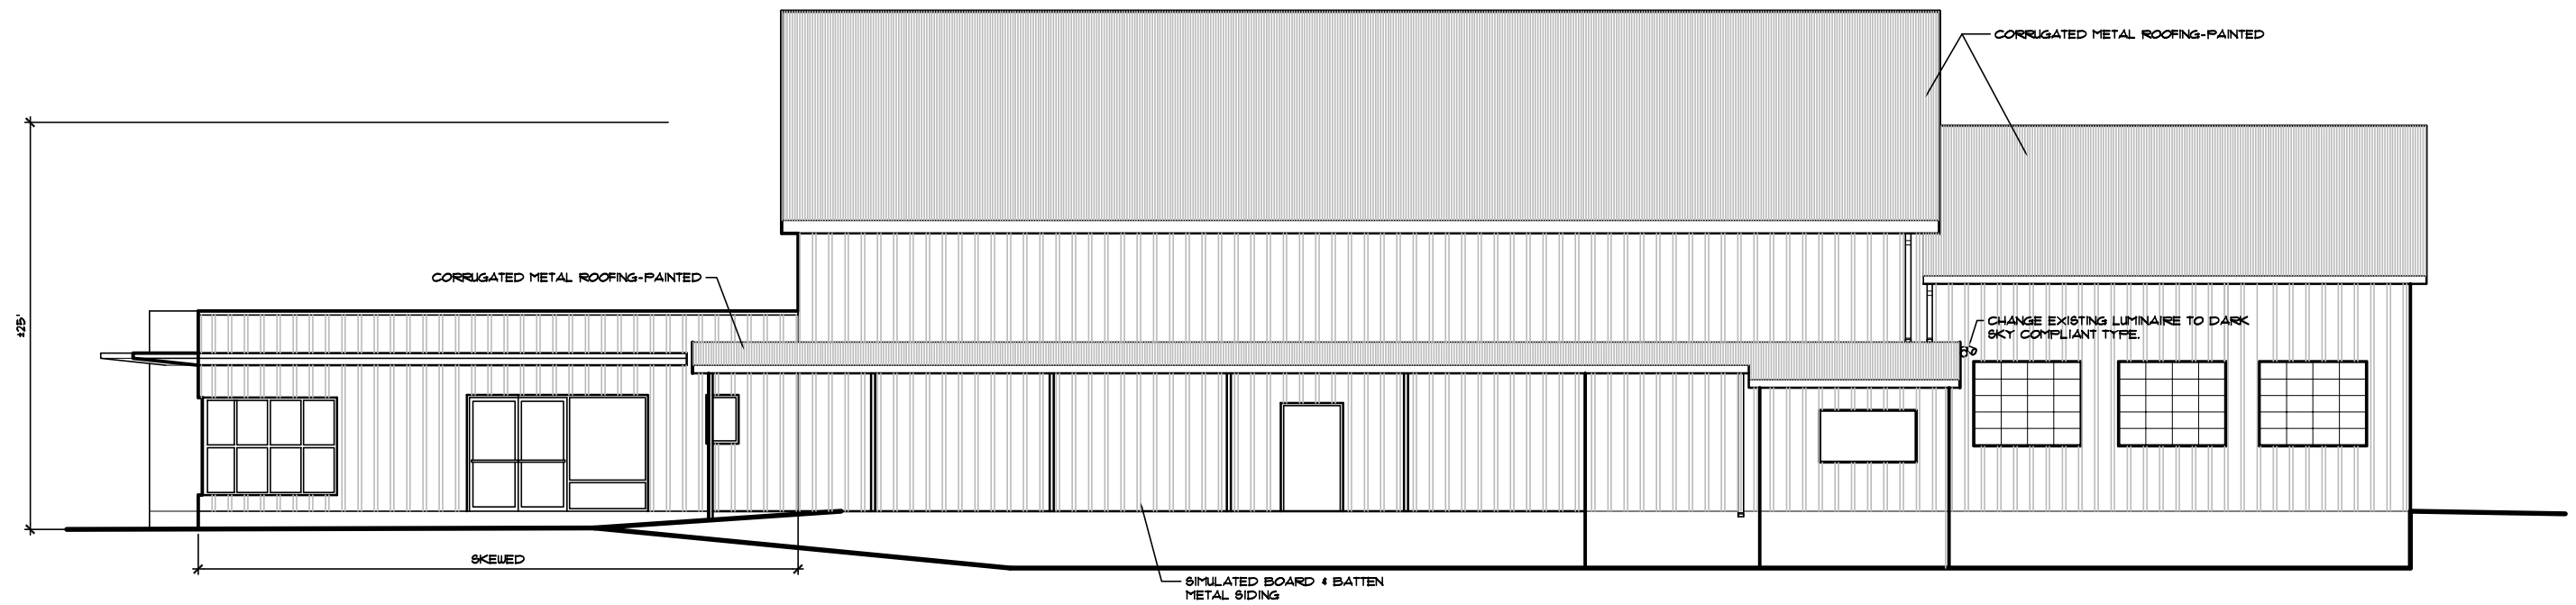

South Elevation
As-Built Sketch

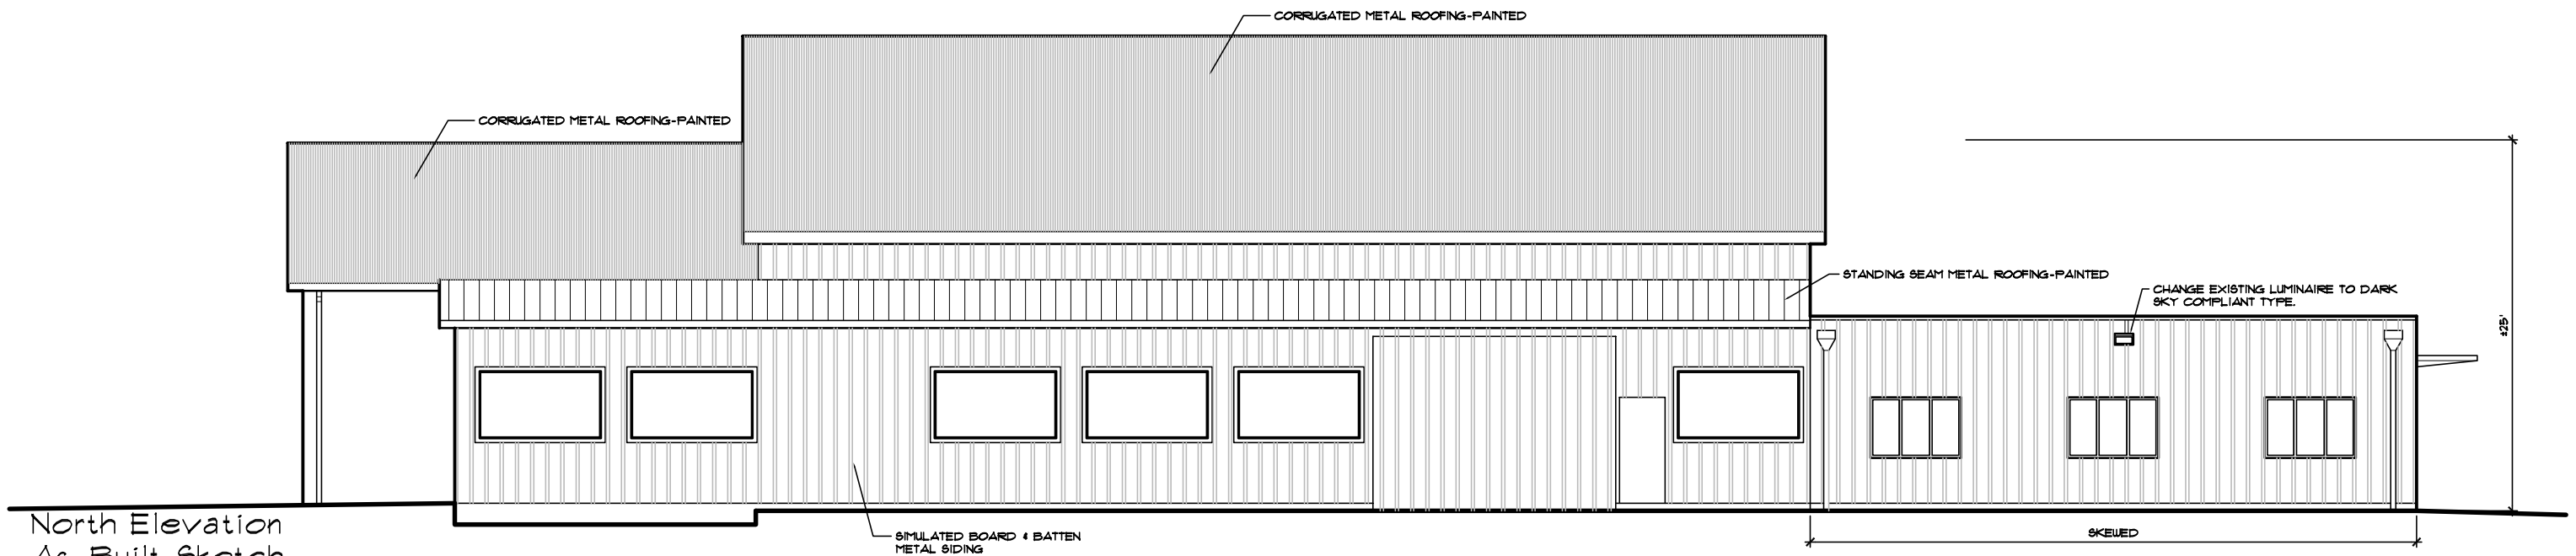


North Elevation
As-Built Sketch


New Horizon Utility Construction. LLC. - Building

KEYSTONE Architecture Planning and Project Management LLC
T: 503-761-1362 F: 503-760-0534

3/32" = 1'-0"
9/18/23

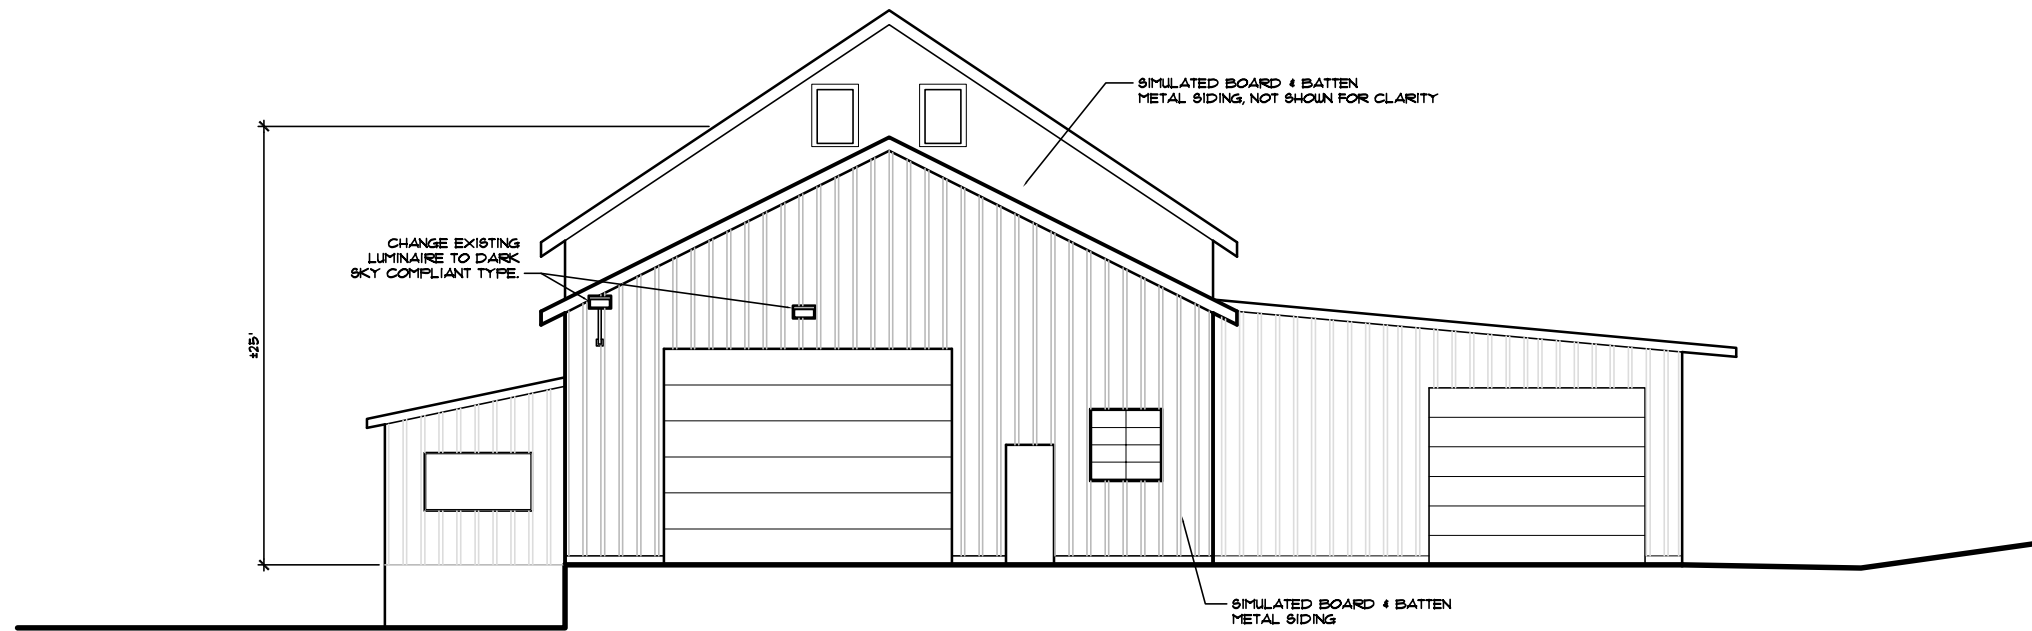

East Elevation
As-Built Sketch

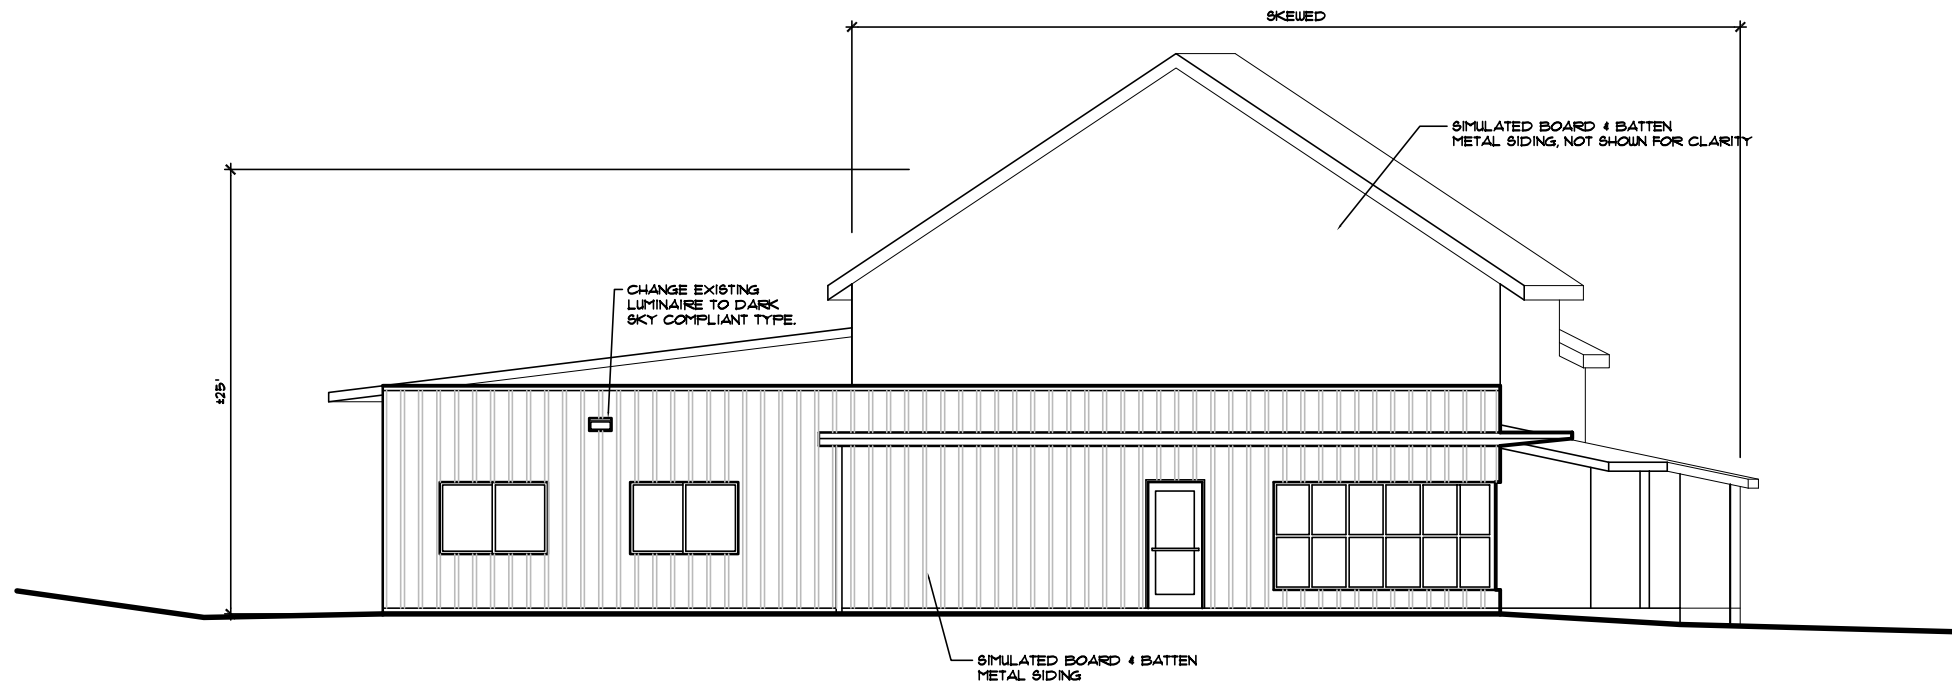

West Elevation
As-Built Sketch

New Horizon Utility Construction. LLC. - Building

KEYSTONE Architecture Planning and Project Management LLC
T: 503-761-1362 F: 503-760-0534

3/32" = 1'-0"
9/18/23